


**ZINN GEOLOGY**  
**GEOLOGIC SITE MAP**  



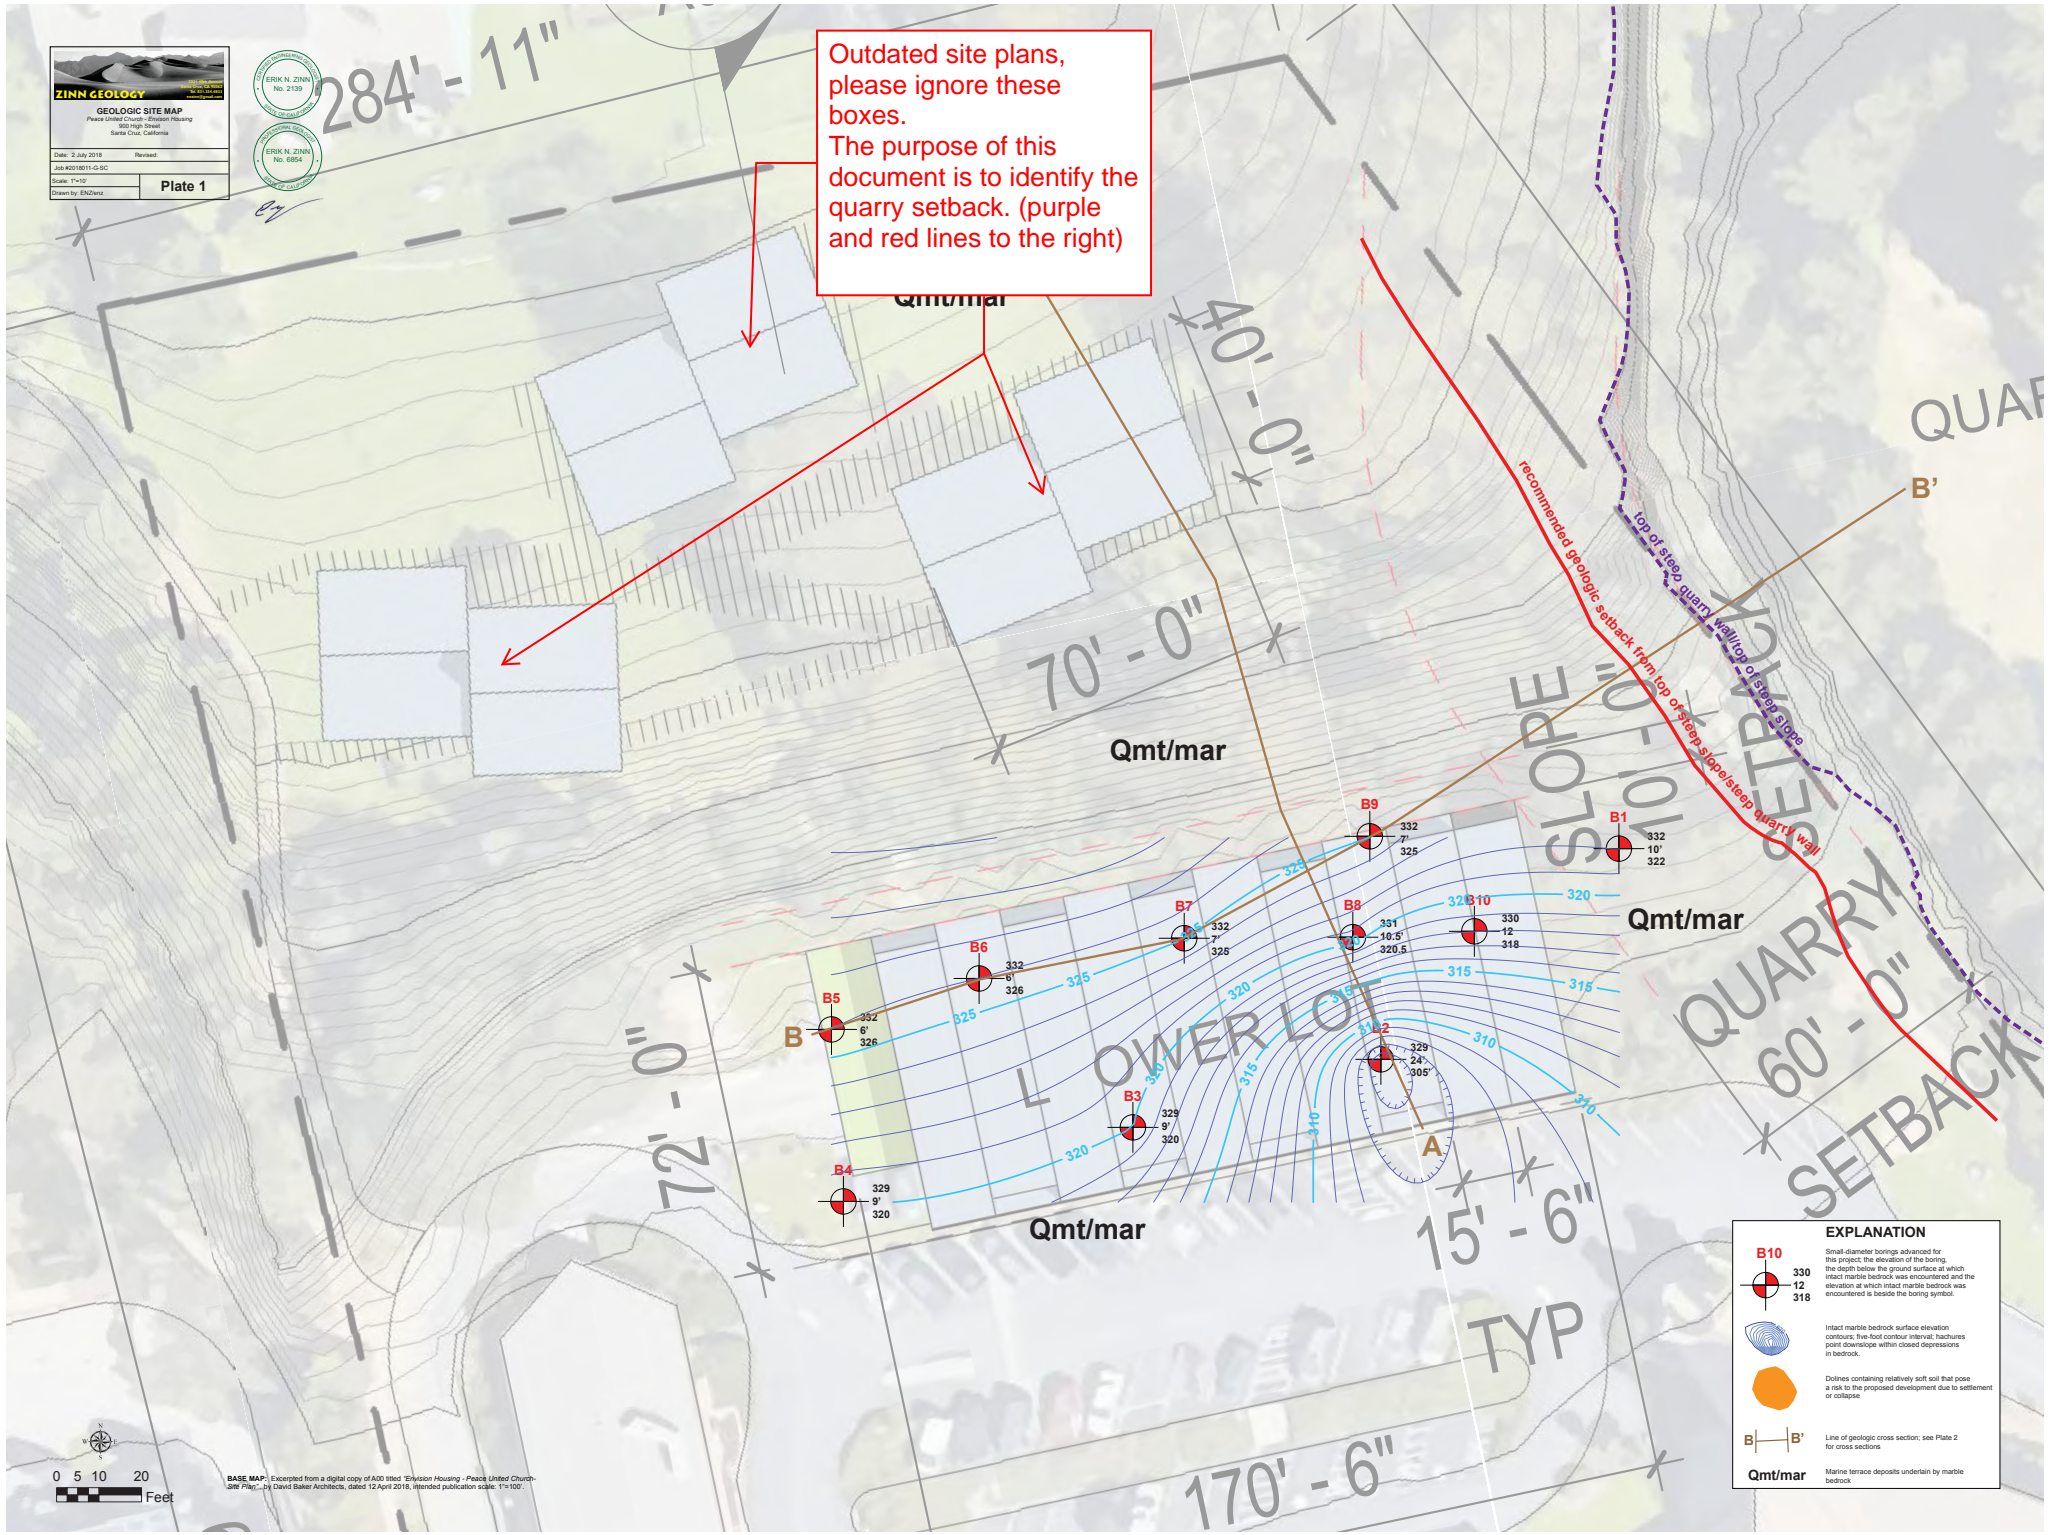

Outdated site plans, please ignore these boxes.  
 The purpose of this document is to identify the quarry setback. (purple and red lines to the right)



EXPLANATION	

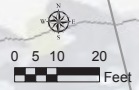

